


Appendix A
Levee and Barrier Wall As-Built Drawings

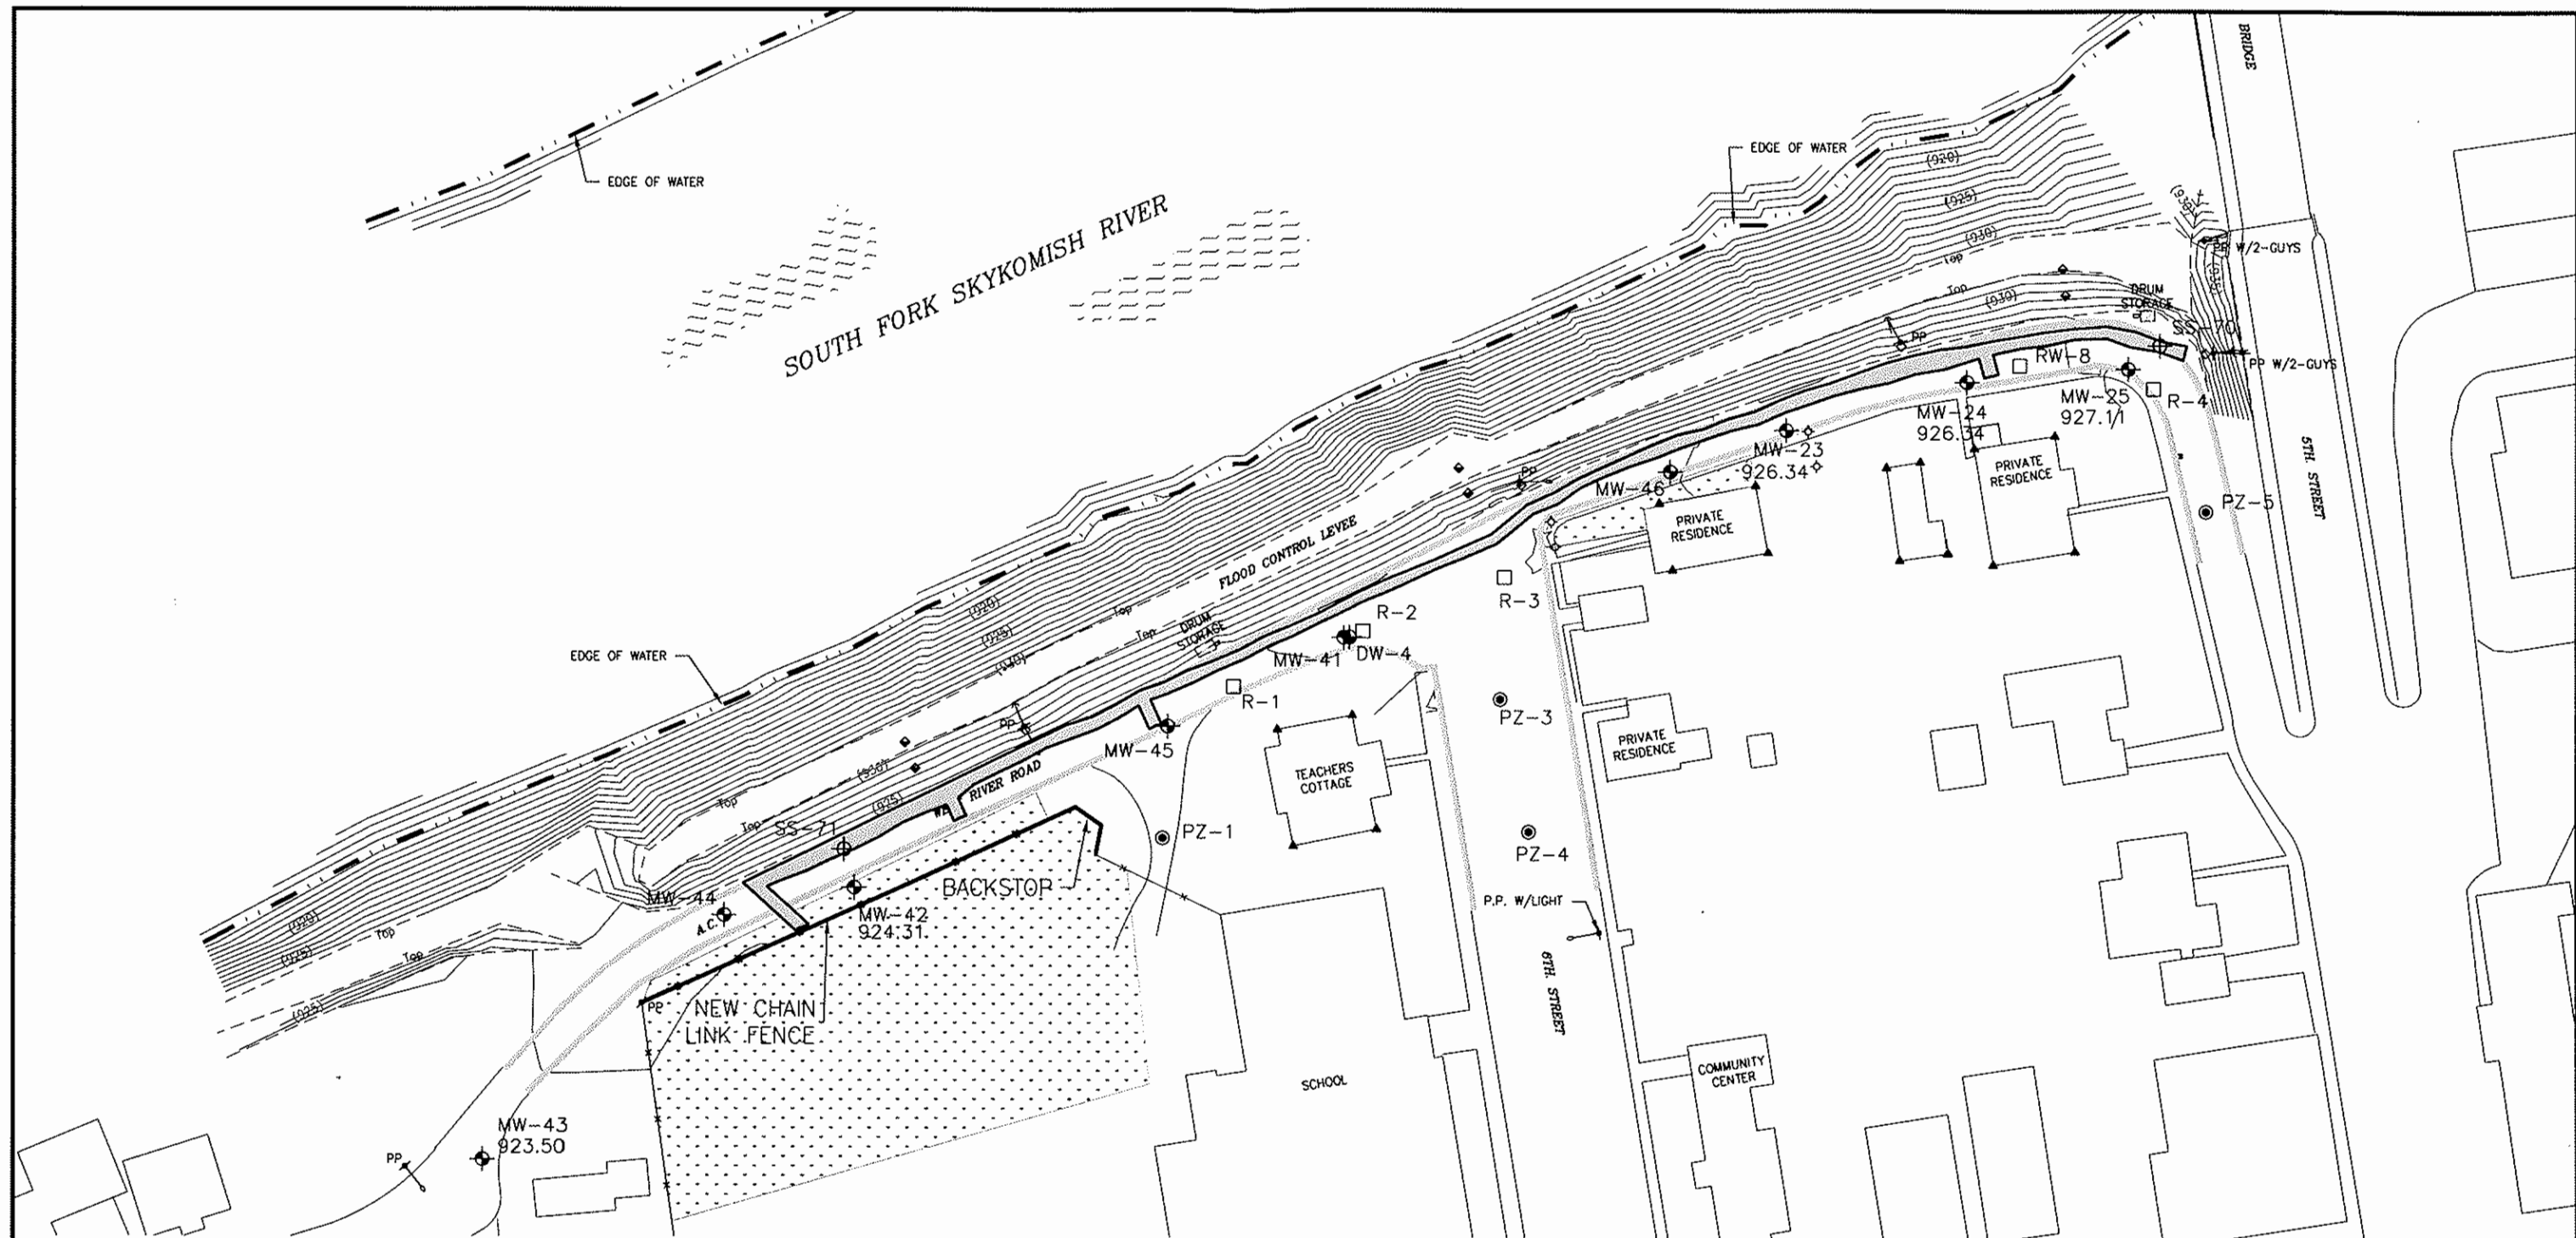

LEGEND






	LOCATION OF AS-BUILT BARRIER WALL		STREET LIGHT
	BUILDING LINE		LOCATION OF NEW SOD
	FENCE		
	EXISTING MONITORING WELL LOCATION	SURVEY MONITORING POINTS	
	EXISTING RECOVERY WELL LOCATION		LEEVE POINTS
	EXISTING PIEZOMETER WELL LOCATION		UTILITY POLE POINTS
	ROAD BASE SAMPLE		STRUCTURE POINTS
			CONTROL POINTS

SCALE IN FEET

NOTE: BASEMAP OBTAINED FROM BUSH, ROED & HITCHINGS TOPOGRAPHIC SURVEY, JOB NO. 9528002, MARCH 1, 2001.



PHASE 1 INTERIM ACTION BNSF - SKYKOMISH, WA BN050-04018-470			AS-BUILT BARRIER WALL LOCATION	
DATE: 12/19/01	DRWN: A.S./UKN	FILE: 4018s260	LAYOUT: ANSI_BI-LJ	FIGURE 3-1

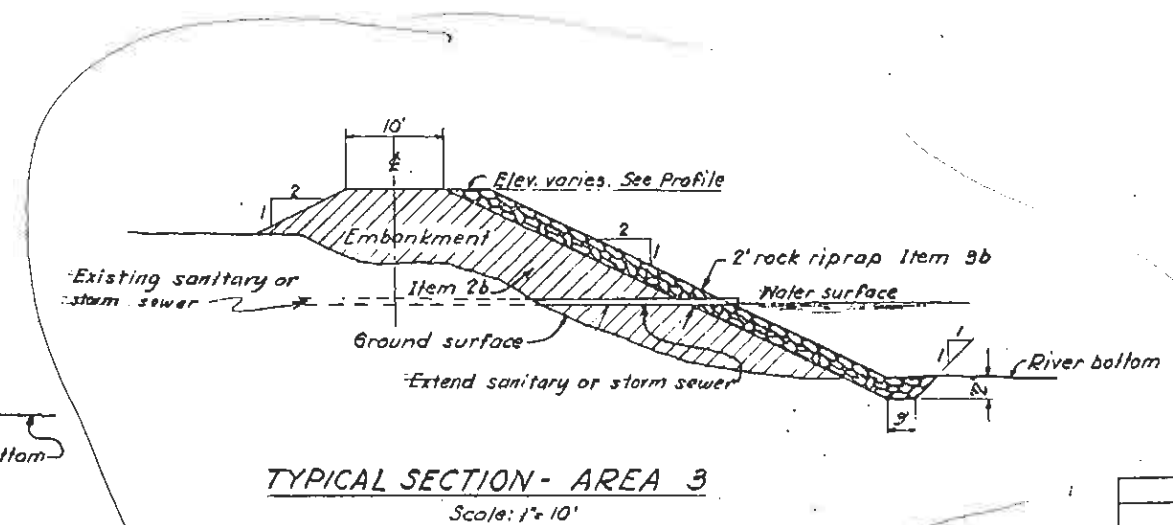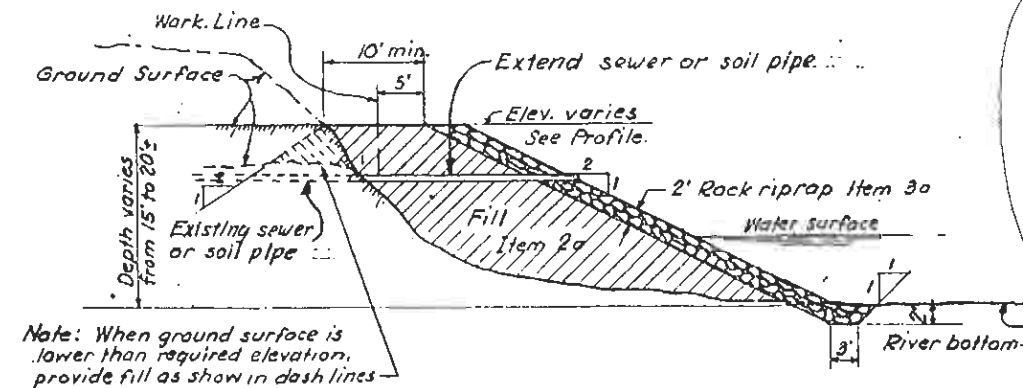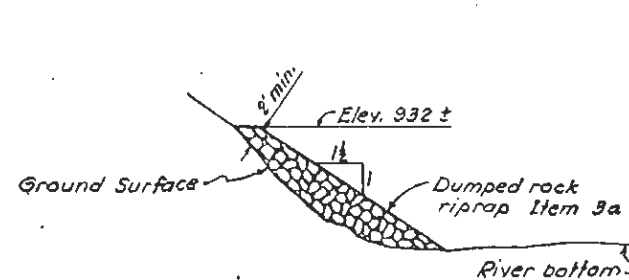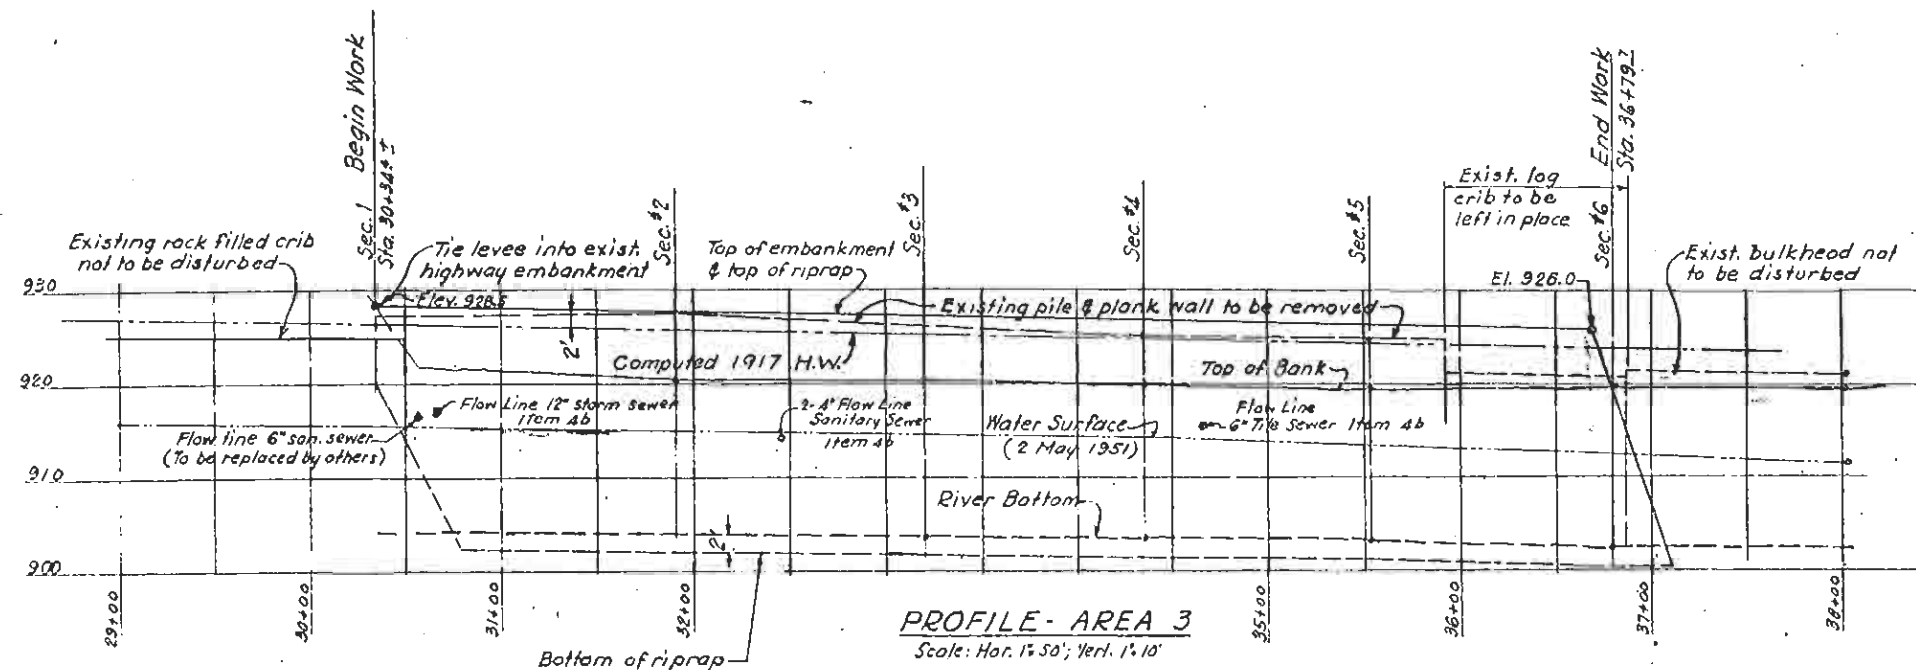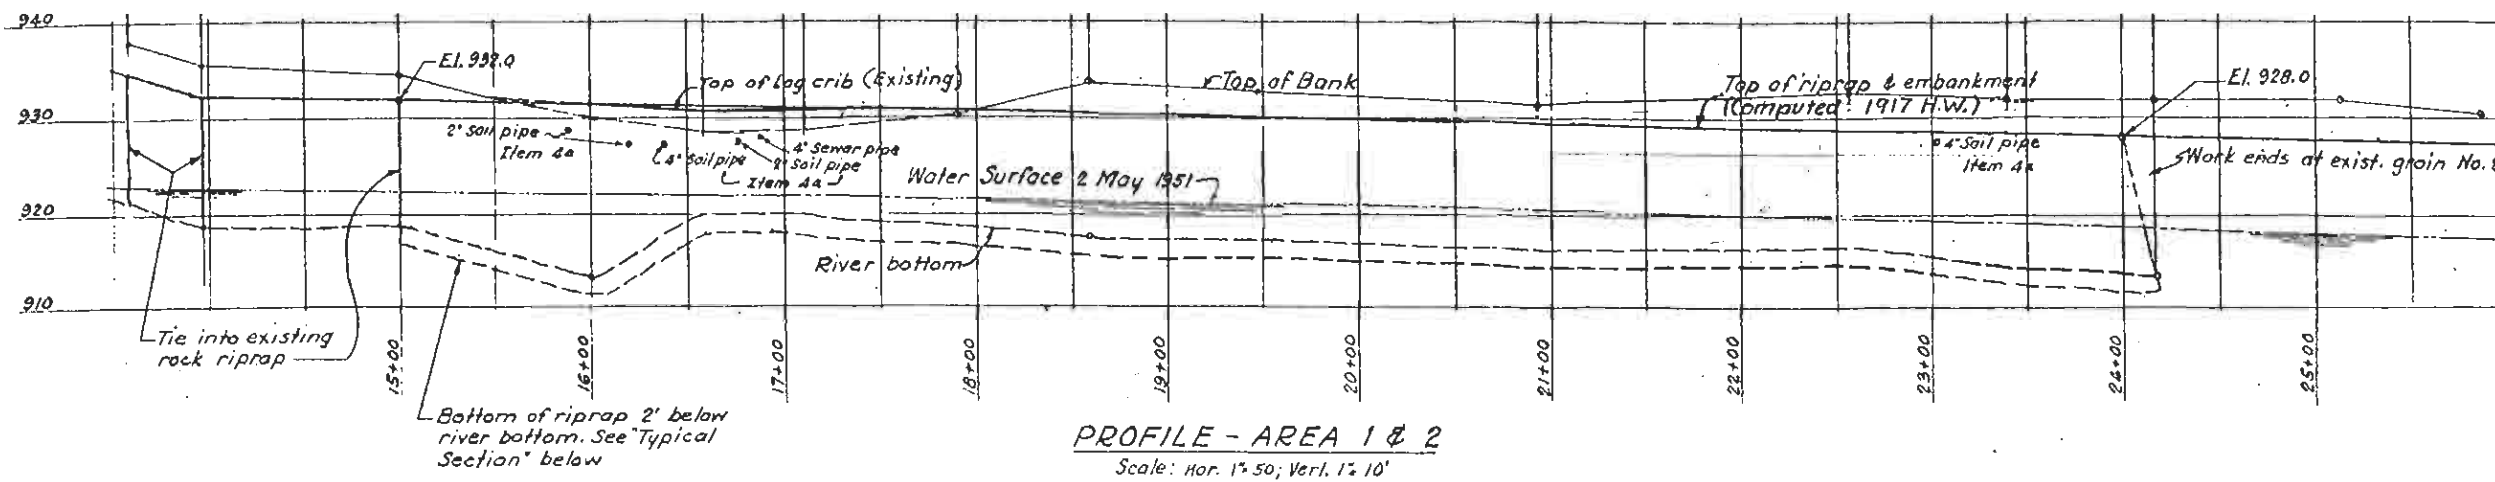

ESTIMATE ARE.

Item No.	Des.
1a	Clea
2a	Emb
3a	Roc
4a	Sewe
1b	Clea
2b	Emb
3b	Roc
4b	Sewe

REVISION	DATE
CORPS OFFICE OF THE D	
DRAWN BY: <i>Jab</i>	
TRACED BY:	
CHECKED BY: <i>Jab</i>	
REVIEWED BY: <i>Jab</i>	
APPROVED BY: <i>Jab</i>	
CHIEF, SAFETY BRANCH	

